


B W A	BERNARDO	WILLS	153 SOUTH JEFFERSON	SPOKANE WASHINGTON 99201	509.838.4511	FAX 509.838.4605	WWW.BERNARDOWILLS.COM		COPYRIGHT B	COPYRIGHT BERNARDO WILLS ARCHITECTS, PC 2011
Project No: 13-173 Drawn by: Date: Noted A1.1	ARCHITECTS PC		Southgate Regal Place - Pad D Black Properties 4919 S. Regal Street Spokane, Washington	Pad D		Construction - 11.27.13 Architectural Site Plan	- 11.27.13	Revision Date: Total City Review Comments 11.27.2013 Added Detail		4198 REGISTERED ARCHITECT ARCHITECT ARCHITECT ARCHITECT STATE OF WASHINGTON

4 EXPANSION & CONTRACTION L-5 JOINTS 5 CONCRETE FLATWORK L-5	
3 BIKE RACK 3 BOULDER DETAIL 1-5 BOULDER DETAIL 4 L-5 4 L-7 1 L-7 1 BHK RACK 1 BOULDER DETAIL 1 BENCH 1 BENCH	
	BEGAL STREET
	NORTH SCALE: 1"

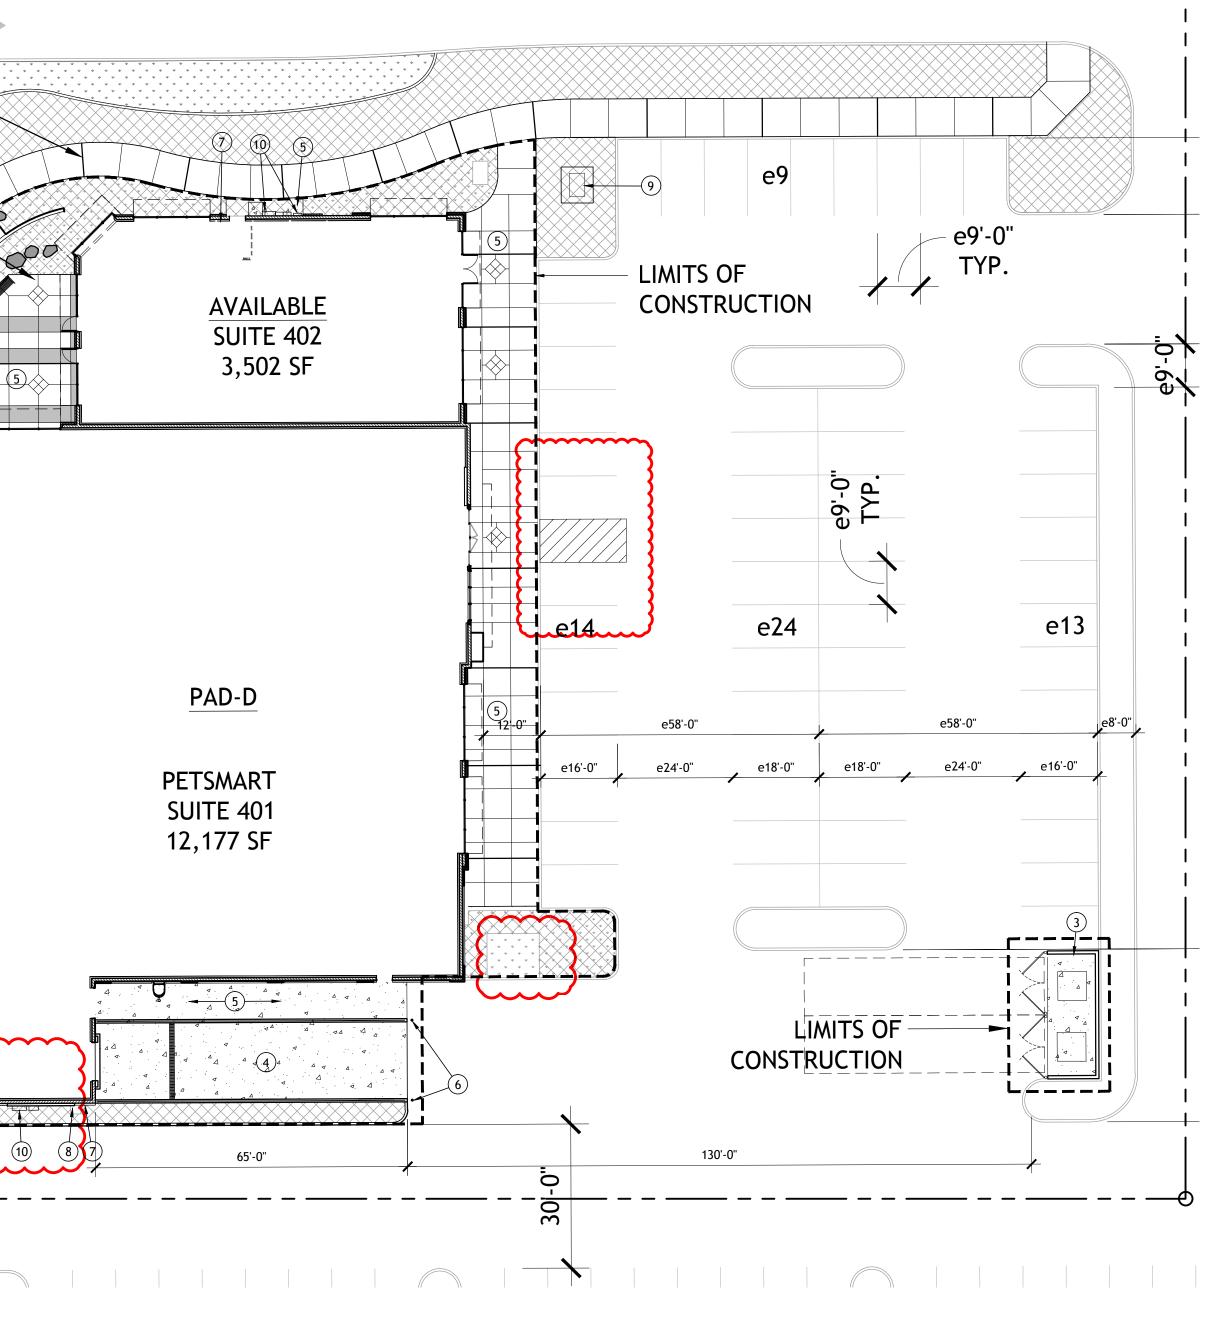

ls Plan

		COPYRIGHT BERNARDO WILLS ARCHITECTS, PC 2011	4198 REGISTERED ARCHITECT ARCHITECT STEL OF WASHINGTON
CONSTRUCT PROPERTY 9 2. COORDINAT ELECTRICAL 3. COORDINAT RESPECTIVE 4. WHEREVER EXPANSION 5. PROVIDE TO THE DESIGN REMOVE AN 6. CONTRACTO 7. CONTRACTO 7. CONTRACTO 8. IN THE EVEN 9. REFER TO P 10. REFER TO D 11. COLORED C 12. IN THE EVEN	DR TO VERIFY LOCATION OF ALL UTILITIES PRIOR TO INITIATION OF ANY DEMOLITION OR FION OPERATIONS. ANY DAMAGE TO EXISTING UTILITIES ON SITE OR ADJACENT SHALL BE CONTRACTOR'S RESPONSIBILITY TO CORRECT. TE ALL DEMOLITION AND CONSTRUCTION OPERATION WITH ARCHITECTURAL, CIVIL, AND L ENGINEERING SHEETS. TE INSTALLATION OF ELECTRICAL AND IRRIGATION CONDUIT AND SLEEVES WITH E CONTRACTORS CONCRETE FLATWORK ABUTS BUILDING, WALL OR COLUMNS IT SHALL HAVE AN	ARDO MILLS 133 SOUTH JEFERSON SPOKANE WASHINGTON 99201 509.338.451 FAX 509.338.4605 WWW.BERNARDOWILLS.COM	CTS PC Construction - 11.27.13 Revision Date: Construction - 11.27.13 Southgate Regal Place - Pad D Black Properties 919 S. Regal Street Sokane, Washington MATERIALS PLAN
		E R N A	RCHITEC

В

A

 \mathbb{N}

B

4


Drawn by:

Date:

Project No: 13-173


Noted


L-2

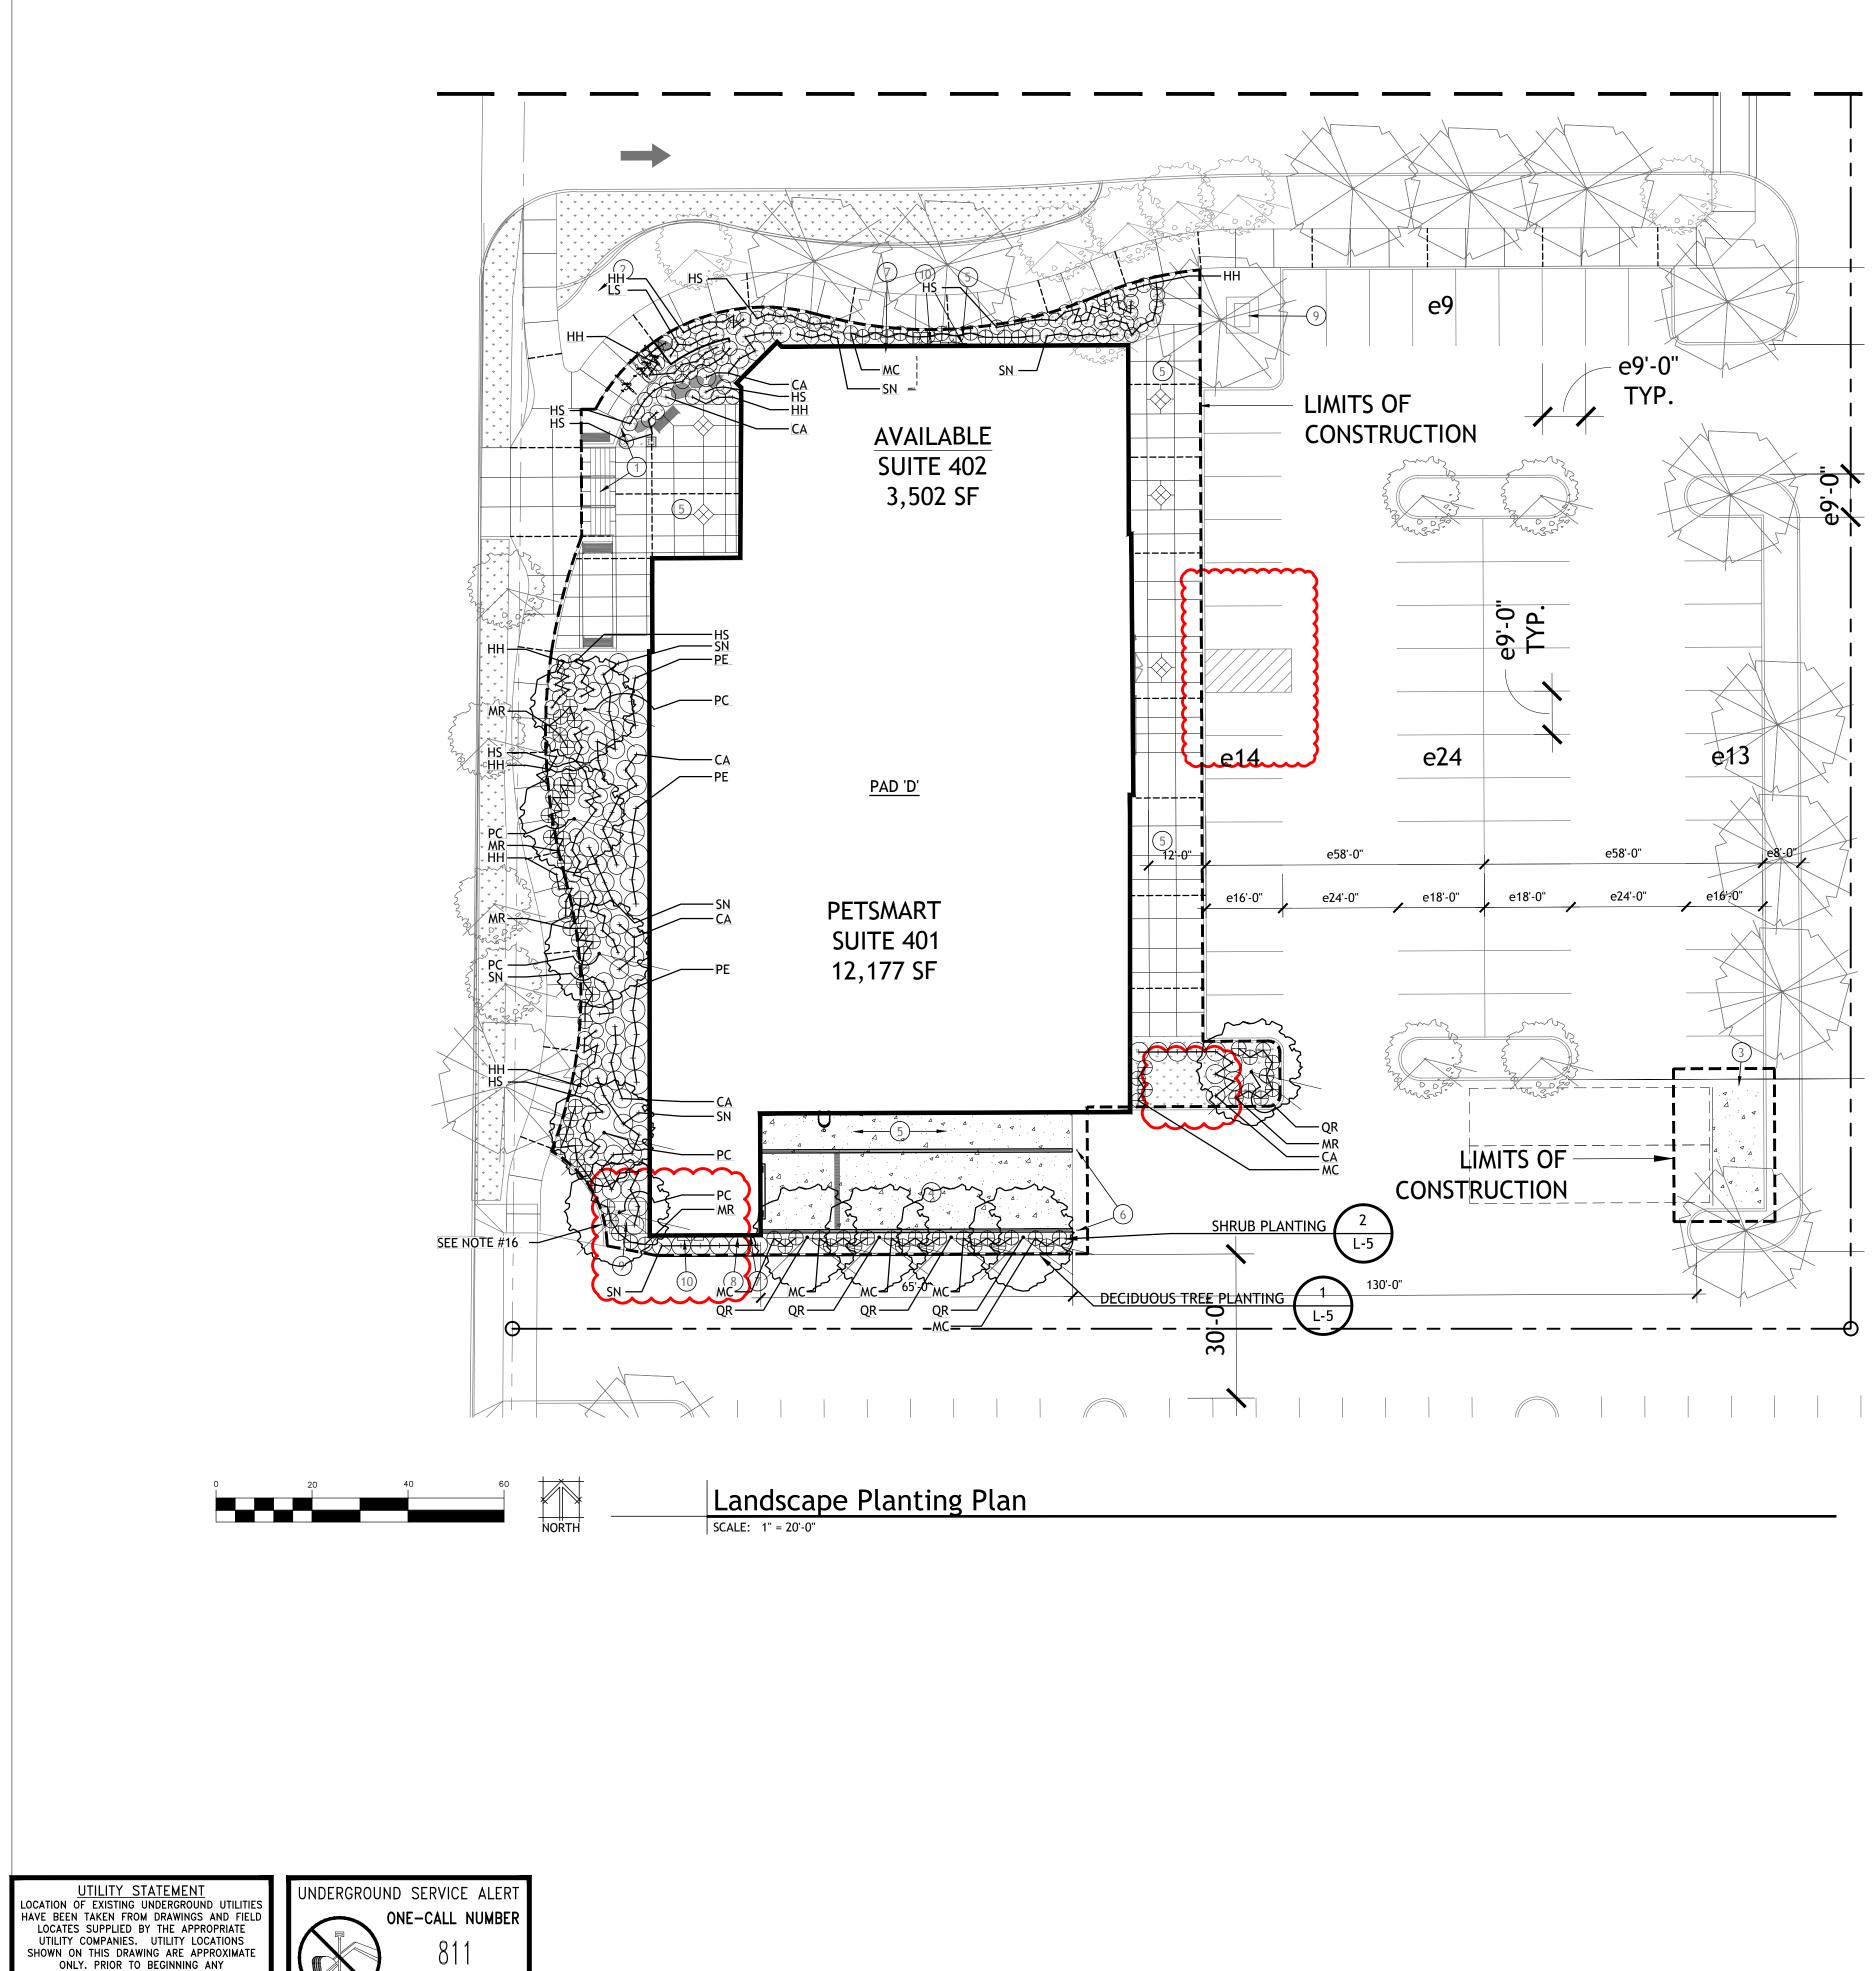

CONSTRUCTION, THE CONTRACTOR SHALL VERIFY THE EXACT LOCATION OF EACH UTILITY

L TWO BUSINESS DAY BEFORE YOU DIG

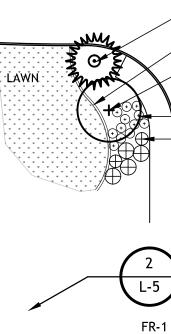

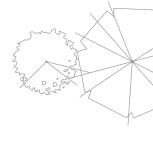

		PLANT LIST - TRI	EES			
KEY	NO.	BOTANICAL - COMMON NAME	SIZE	TYPE	REMARKS	
		LARGE TREES				
QS	-	QUERCUS ROBUR X Q. ALBA - CRIMSON SPIRE OAK	3" CAL.	B&B	MATCHED	
		SMALL & FLOWERING TREES				45'H
PC	-	PRUNUS SARGENTII 'COLUMNARIS' - COLUMNAR SARGENT CHERRY	2.5" CAL.	B&B	MATCHED	

		PLANT LIST - SHRUBS / GROUND	COVER	S	
KEY	TOTAL NO.	BOTANICAL - COMMON NAME	SIZE	TYPE	REMARKS
		SHRUBS			
HH	-	HEMEROCALLIS X 'STELLA DE ORO' - STELLA DE ORO DWARF DAYLILLY	1 GAL.	CONT.	MATCHED
LS	-	LAVANDULA STOECHAS 'LARKMAN HAZEL' - HAZEL SPANISH LAVENDER	2 GAL.	CONT.	MATCHED
MC	-	MAHONIA AQUIFOLIUM 'COMPACTA' - COMPACT OREGON GRAPE	2 GAL.	CONT.	MATCHED
PE	-	PHYSOCARPUS OPULIFOLIUS 'SEWARD' - SUMMER WINE NINEBARK	5 GAL.	CONT.	MATCHED
SN	-	SPIRAEA NIPPONICA 'SNOWMOUND' - SNOWMOUND SPIREA	2 GAL.	CONT.	MATCHED
		GROUNDCOVERS			
MR	-	MAHONIA REPENS - CREEPING MAHONIA	1 GAL.	CONT.	MATCHED
		ORNAMENTAL GRASSES			
CA	-	CALAMAGROSTIS X ACUTIFLORA 'KARL FOERSTER' - FEATHER REED GRASS	2 GAL.	CONT.	MATCHED
HS	-	HELICTOTRICHON SEMPERVIRENS - BLUE OAT GRASS	2 GAL.	CONT.	MATCHED
		TURF GRASS			
	-	SOD - NOT IN CONTRACT - PER TARGET DEVELOPMENT			

NOTES

- 3.
- PLAN LOCATIONS SHALL DICTATE COUNT.
- 25% COMPOST TO NATIVE SOIL).
- TO NATIVE SOIL).
- LIMITS.

LEGEND

- EVERGREEN TREES - 6" WIDE EXTRUDED CONCRETE EDGING BETWEEN LAWN AND LANDSCAPE SHRUB BEDS. (SEE DETAILS) – DECIDUOUS TREES _ DECIDUOUS SHRUBS / GROUNDCOVERS/ ORNAMENTAL GRASSES - EVERGREEN SHRUBS / GROUNDCOVERS DETAIL NUMBER — DETAIL CALLOUT PAGE NUMBER — IDENTIFICATION KEY - PLANT QUANTITY BASALT BOULDERS. SIZE SHALL BE EQUALLY 00 DIVIDED INTO 3 SIZE RANGES: 2'-3', 3'-4', AND 4'-5'. USED DRAWINGS AS GUIDE TO SIZE PLACEMENT ON SITE.

TREES - NOT IN CONTRACT - PER TARGET 7 DEVELOPMENT

1. CONTRACTOR TO VERIFY LOCATION OF ALL UTILITIES PRIOR TO INITIATION OF ANY DEMOLITION OR CONSTRUCTION OPERATIONS. ANY DAMAGE TO EXISTING UTILITIES ON SITE OR ADJACENT PROPERTY SHALL BE CONTRACTOR'S RESPONSIBILITY. ALL PLANT MATERIAL SHALL CONFORM TO THE AMERICAN ASSOCIATION OF NURSERYMAN'S; AMERICAN STANDARD FOR NURSERY STOCK, ANSI Z60.1-2004. FOR ADDITIONAL PLANT REQUIREMENTS.

4. ALL PLANT MATERIAL SHALL BE INSTALLED AS PER DETAILS. 5. CONTRACTOR SHALL VERIFY ALL QUANTITIES. IN THE CASE OF A DISCREPANCY BETWEEN THE PLANT SCHEDULE AND PLAN, THE

CONTRACTOR SHALL COORDINATE PLANTING WITH IRRIGATION CONTRACTOR. NO SUBSTITUTIONS WILL BE ALLOWED WITHOUT THE WRITTEN CONSENT OF THE LANDSCAPE ARCHITECT.

8. THE TOP SOIL LAYER OF ALL TURF AREAS SHALL RECEIVE (4") OF TOPSOIL MIX (COMPOST MIXED WITH NATIVE SOIL AT A RATE OF

9. ALL PLANTING BEDS SHALL HAVE AN 18" DEPTH OF TOPSOIL MIX (COMPOST MIXED WITH NATIVE SOIL AT A RATE OF 25% COMPOST

10. ALL SHRUB BEDS SHALL RECEIVE A MIN. OF 3" DEPTH OF "TUSCAN PATHWAY". BY WITTKOPF OR EQUAL. 11. SHRUB BED EDGING SHALL BE 6" X 6" EXTRUDED CONCRETE. IT SHALL SEPARATE ALL TURF AREAS FROM PLANTING BED


LOCATIONS. SEE PLANS FOR SPECIFIC LOCATIONS. 12. ALL PLANTS AND PLANT STAKES SHALL BE SET PLUMB UNLESS OTHERWISE NOTED.

13. ALL ROOT WRAPPING MATERIAL MADE OF SYNTHETICS SHALL BE REMOVED AT THE TIME OF PLANTING. 14. NO BARE ROOT STOCK SHALL BE USED UNLESS OTHERWISE NOTED IN CONTRACT DOCUMENTS.

15. CONTRACTOR IS RESPONSIBLE FOR LOCATING PROPERTY LINES AND WORKING WITHIN THE PROPERTY BOUNDARY AND PROJECT

16. REMOVE AND DISPOSE OF MOW CURB OFFSITE, WITH THE DEVELOPMENT OF THE LANDSCAPE AT PAD 'D'. 17. ALL EXISTING LANDSCAPE SHALL BE PROTECTED THROUGHOUT THE CONSTRUCTION PROCESS. ANY LANDSCAPE DAMAGED DURING CONSTRUCTION SHALL BE REPLACED WITH SAME SIZE, TYPE, AND QUALITY PLANT AT NO ADDITIONAL COST TO THE OWNER. 18. IN THE EVENT OF A DISCREPANCY, NOTIFY THE LANDSCAPE ARCHITECT IMMEDIATELY.


B W A	BERNARDO	WILLS	153 SOUTH JEFFERSON	SPOKANE WASHINGTON 99201	509.838.4511	FAX 509.838.4605	WWW.BERNARDOWILLS.COM		COPYRIGHT BERNARDO V	COPYRIGHT BERNARDO WILLS ARCHITECTS,PC 2011
Project No: 13-173 Drawn by: Date: Noted	ARCHITECTS PC		Southgate Regal Place - Pad D Black Properties 4919 S. Regal Street Spokane, Washington	- Pad D		Construction - 11.27.13 LANDSCAPE PLANTING F		Revision Date: T City Review Comments 11.27.2013 Added Detail 11.27.2013		4198 REGISTERED ARCHITECT ARCHITECT ARCHITECT Cary M. BERNARDO STATE OF WASHINGTON

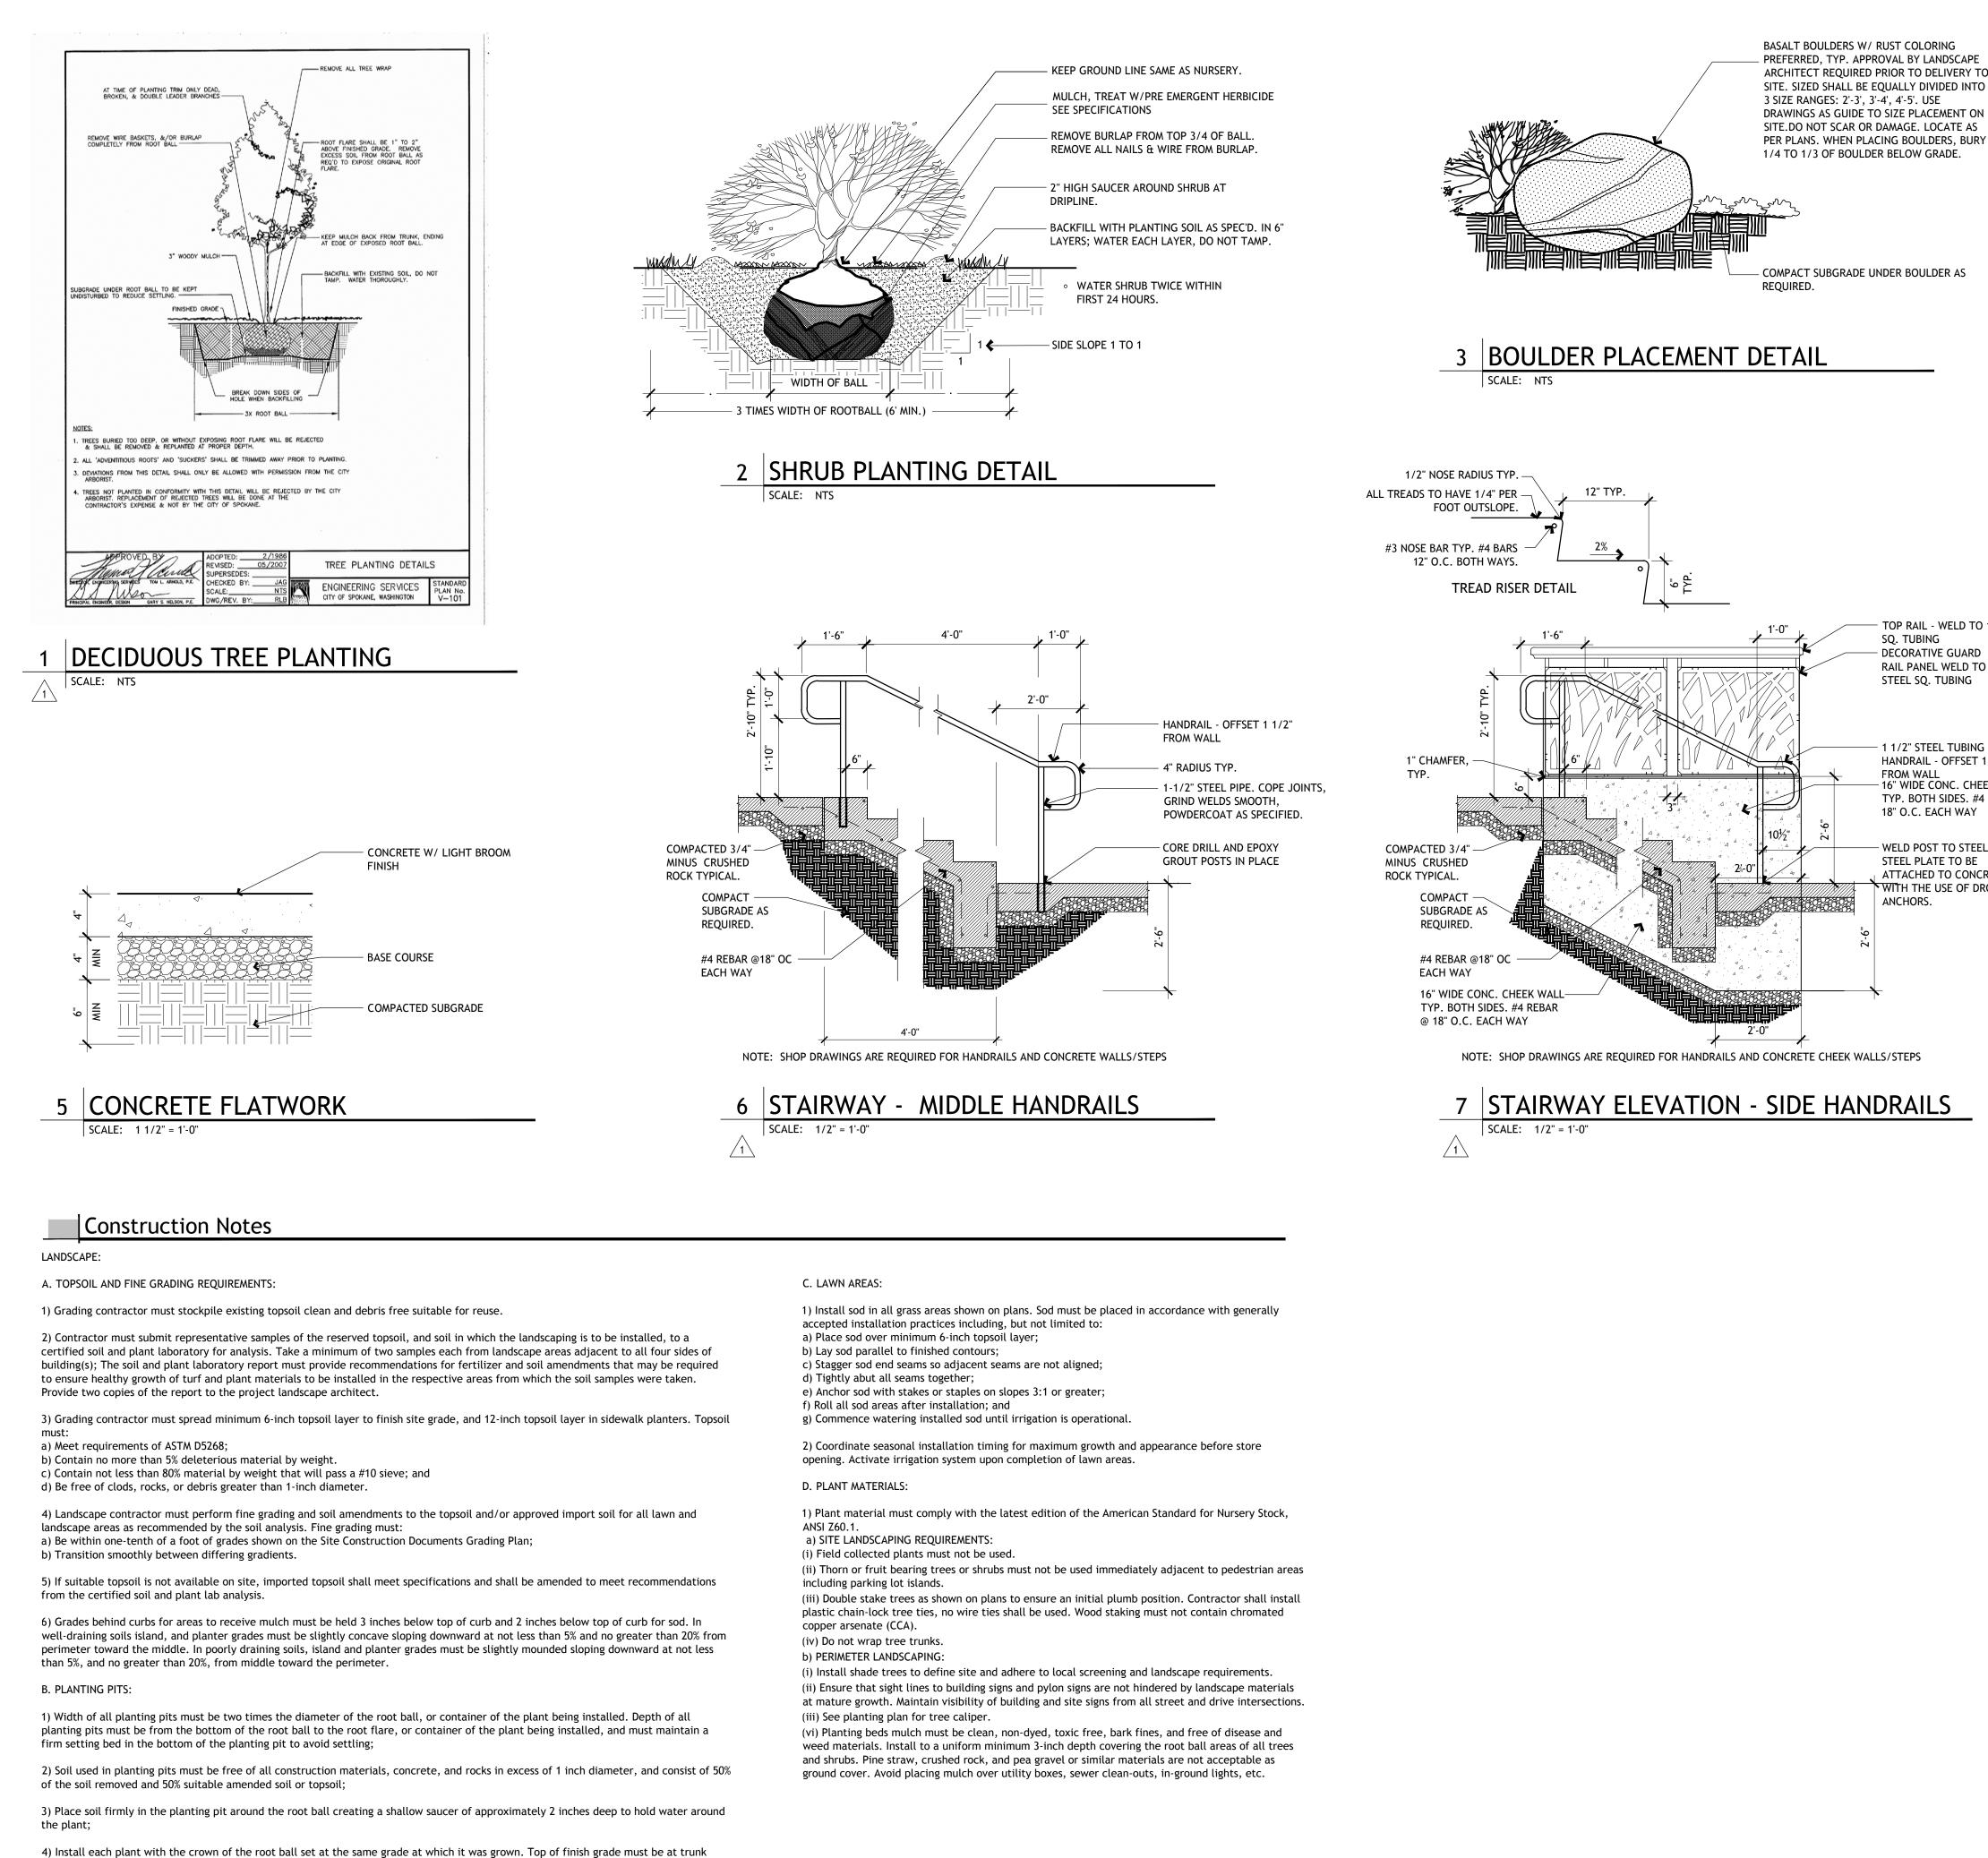

5) Water plants thoroughly upon installation. Backfill any settling of soil around root ball to re-establish initial grade and saucer.

flare.

7 STAIRWAY ELEVATION - SIDE HANDRAILS

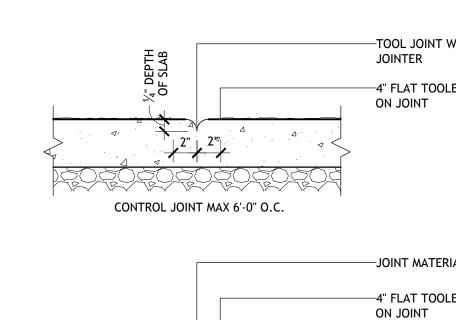

-TOOL JOINT WITH GROOVER/

-4" FLAT TOOLED AREA CENTERED

-JOINT MATERIAL AND SEALANT

-4" FLAT TOOLED AREA CENTERED



EXPANSION JOINT MAX 30'-0" O.C.


TOP RAIL - WELD TO 1" STEEL SQ. TUBING DECORATIVE GUARD RAIL PANEL WELD TO 1 STEEL SQ. TUBING


1 1/2" STEEL TUBING HANDRAIL - OFFSET 1 1/2" FROM WALL 16" WIDE CONC. CHEEK WALL TYP. BOTH SIDES. #4 REBAR @ 18" O.C. EACH WAY

WELD POST TO STEEL PLATE. STEEL PLATE TO BE ATTACHED TO CONCRETE WITH THE USE OF DROPIN


M A	BERNARDO	MILLS			EOO 030 4E11	EAV EAA 020 12AE			
					1104.000.400	LAA 309.636.4603	W W W DERNARDOWILLS.COM		כטדזאוטהו פבאואמאטט אוובגא מאכחו ובכן ארע צטו ו
Dra	ARCHITECTS PC					Construction - 11.27.13	11.27.13	Revision Date:	
oject awn te:	_		Southgate				1	<u>∕1 \ Added Detail</u> 11.∠/.∠U13	4198 REGISTERED
			Regal Place - Pad D	Pad D					Buand
			Black Properties						GARY M. BERNARDO STATE OF WASHINGTON
B-173 loted			Spokane, Washington			LANDSCAPE DETAILS	ETAILS		

- 7

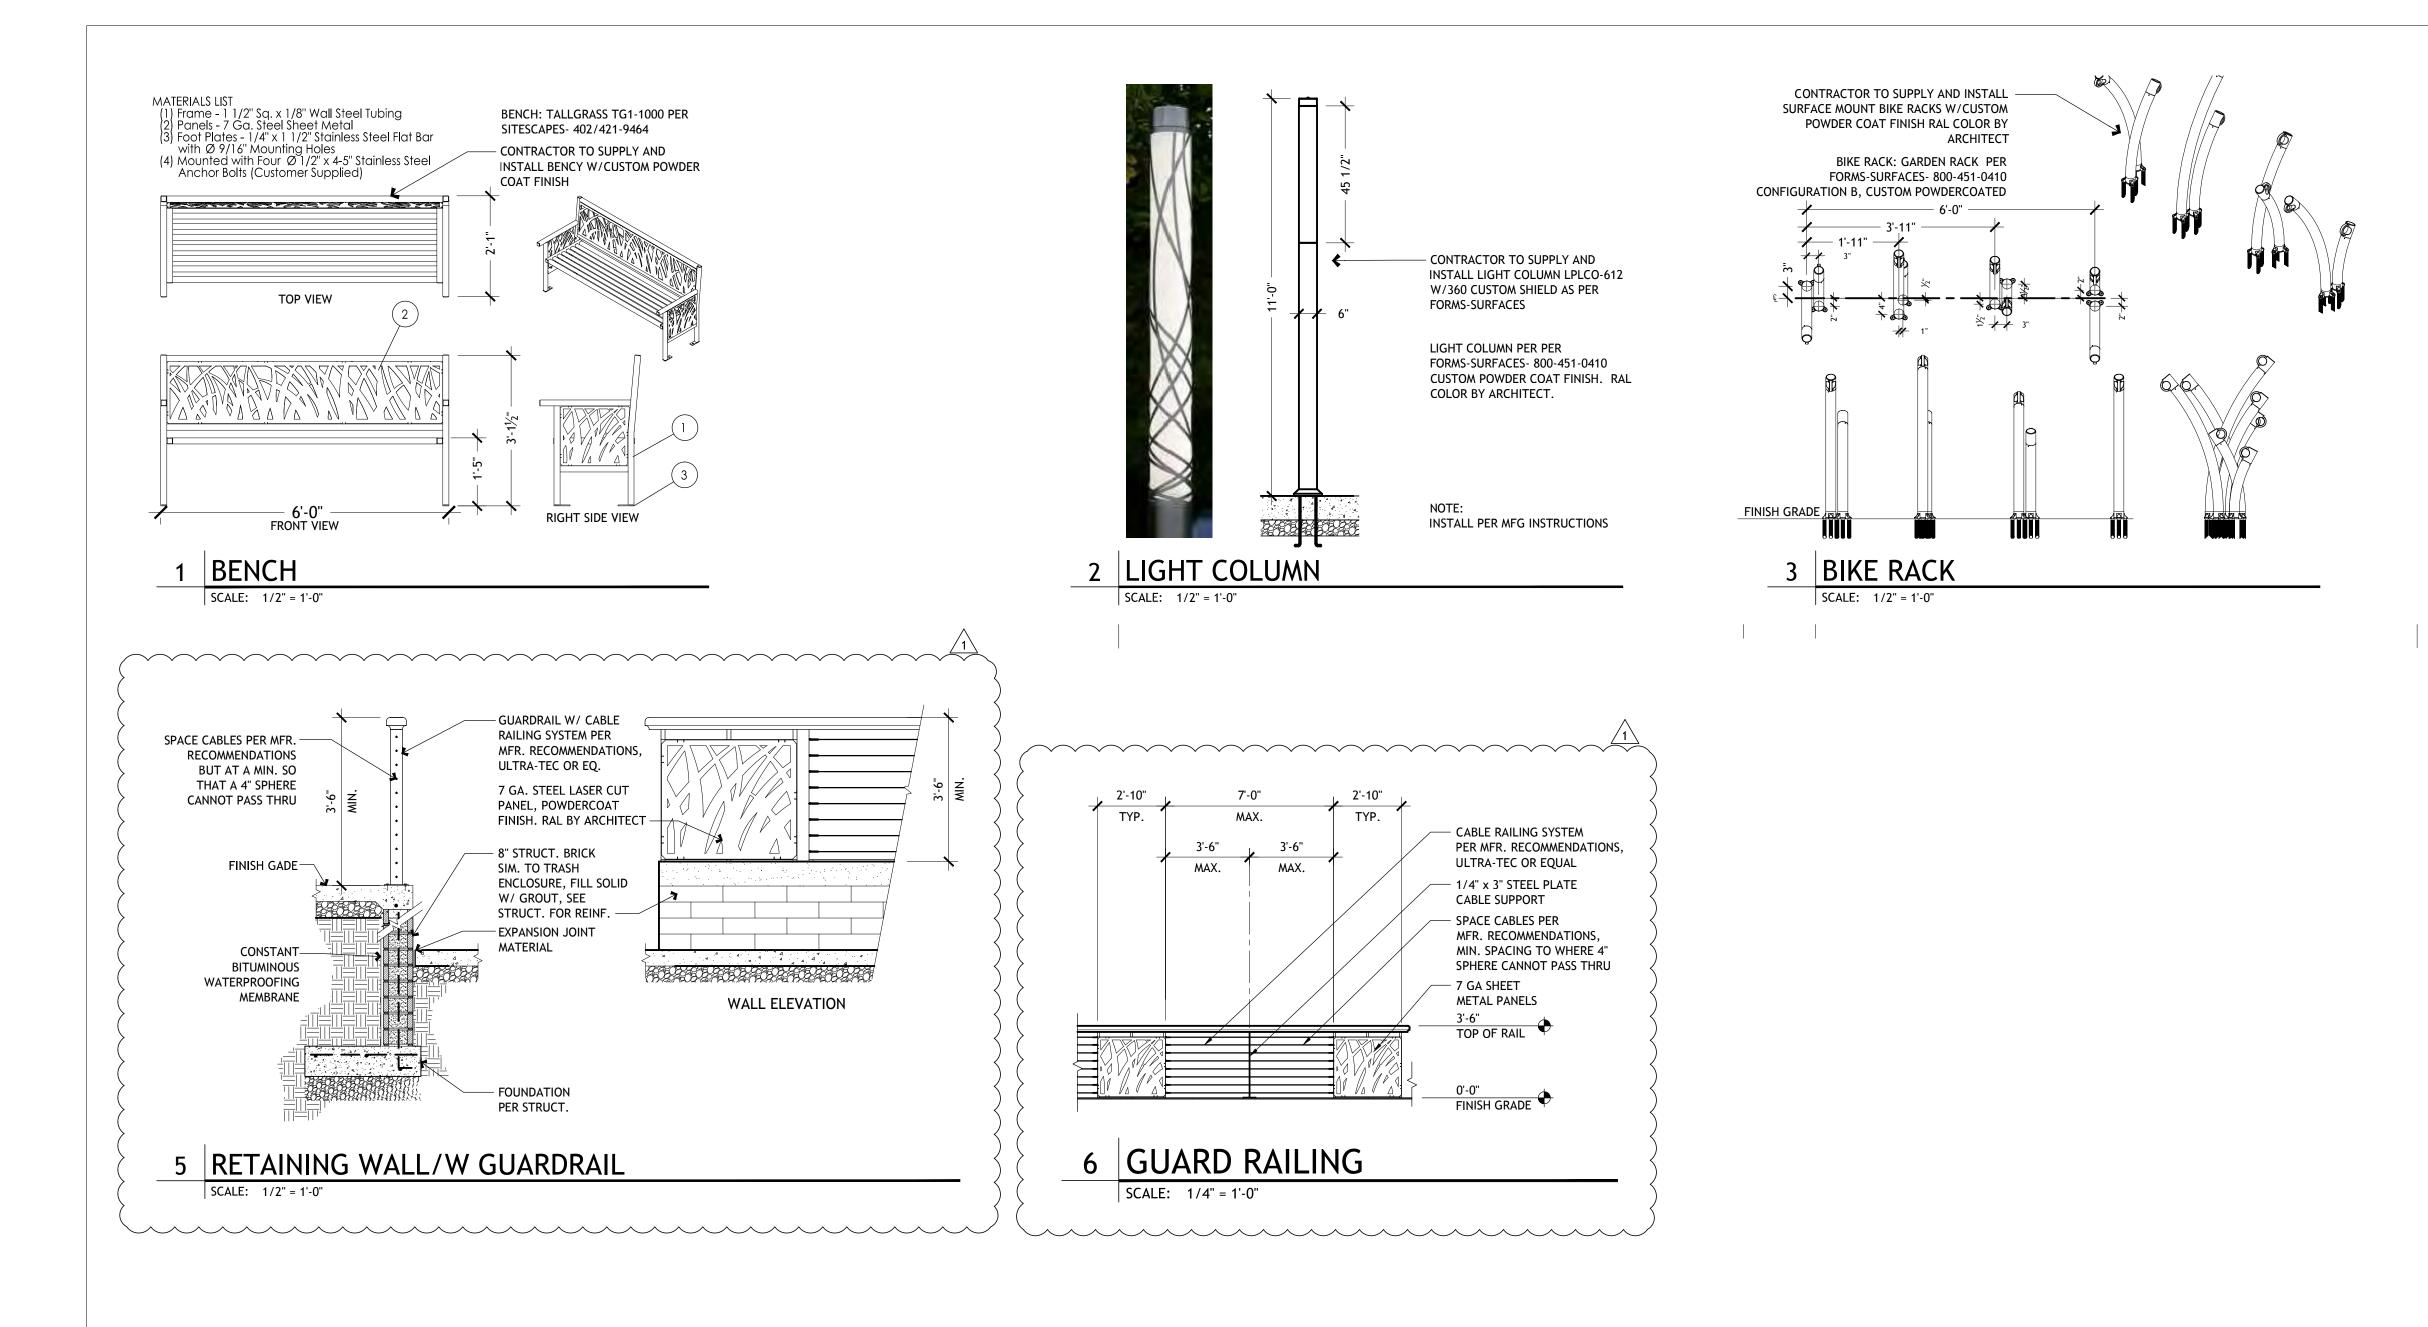

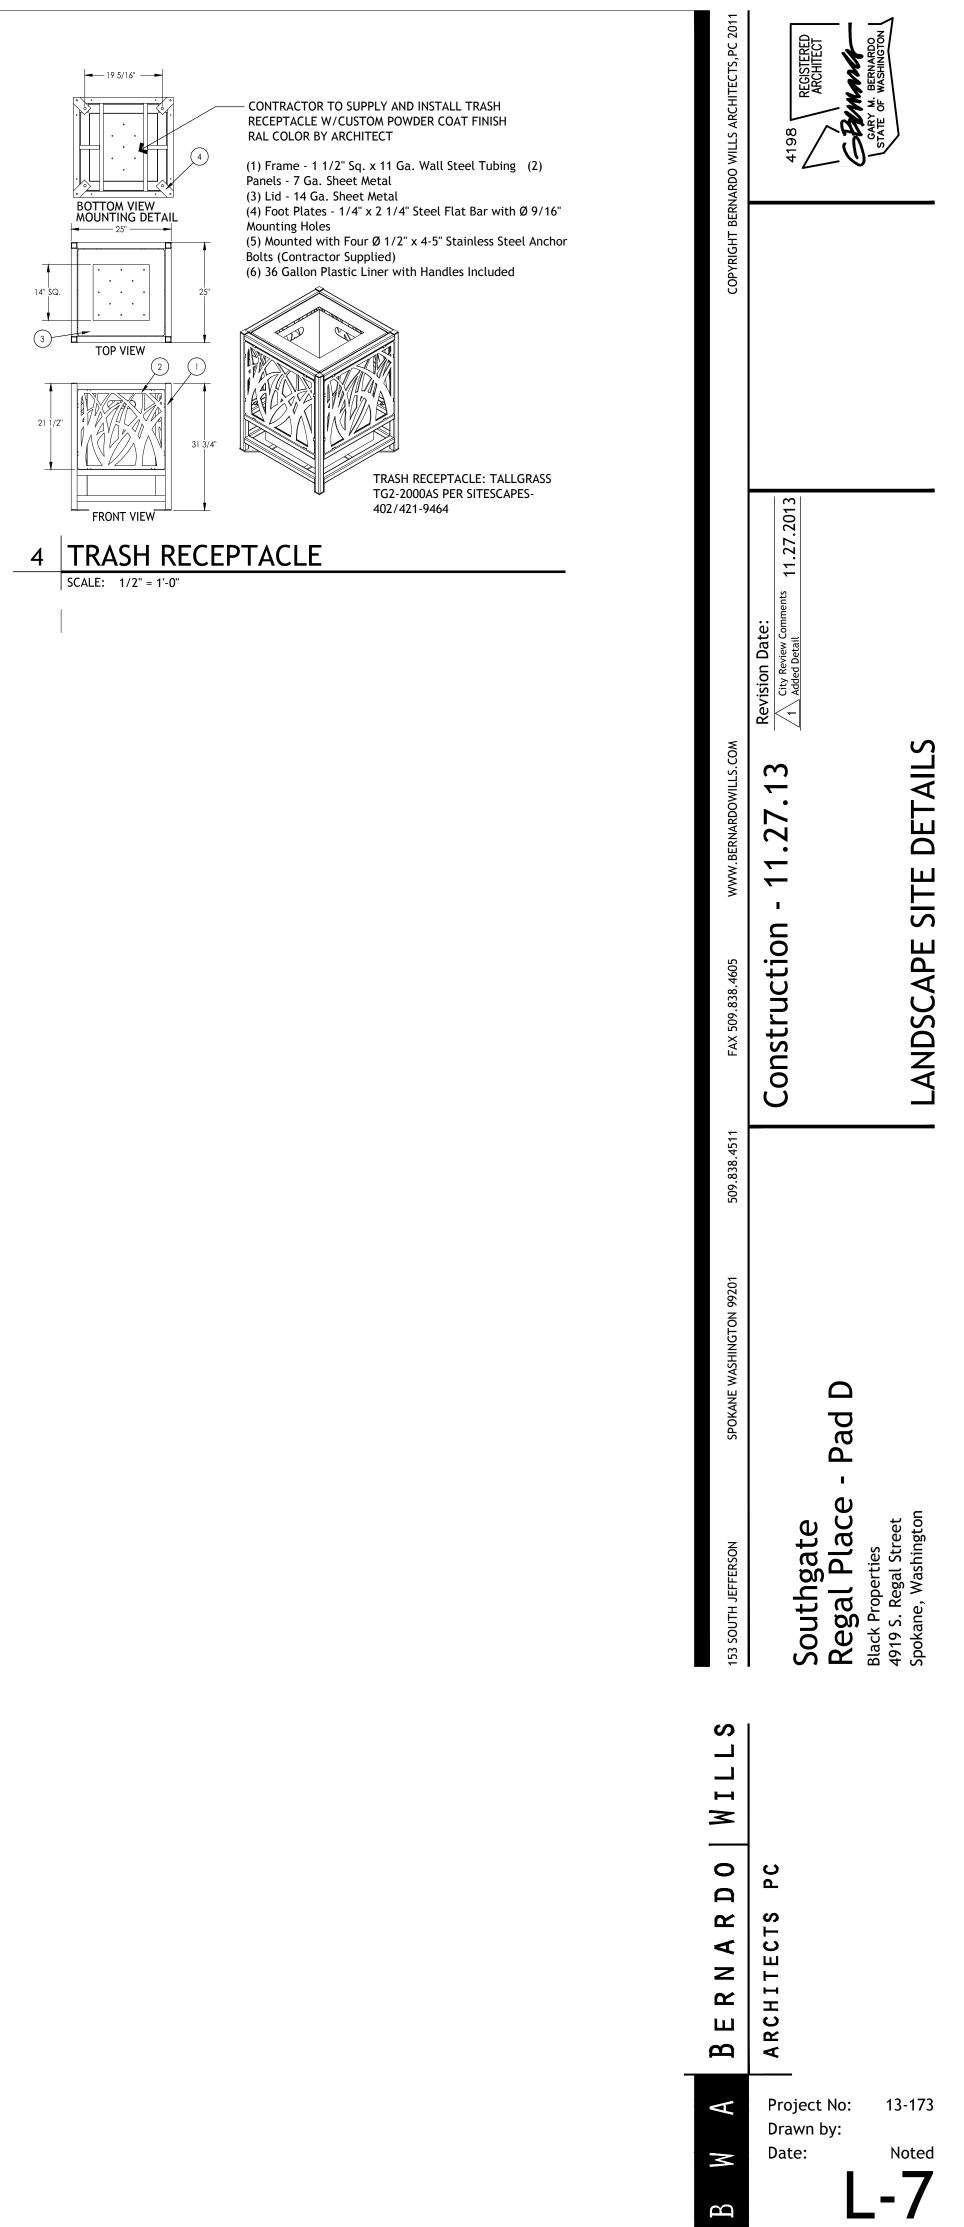

В

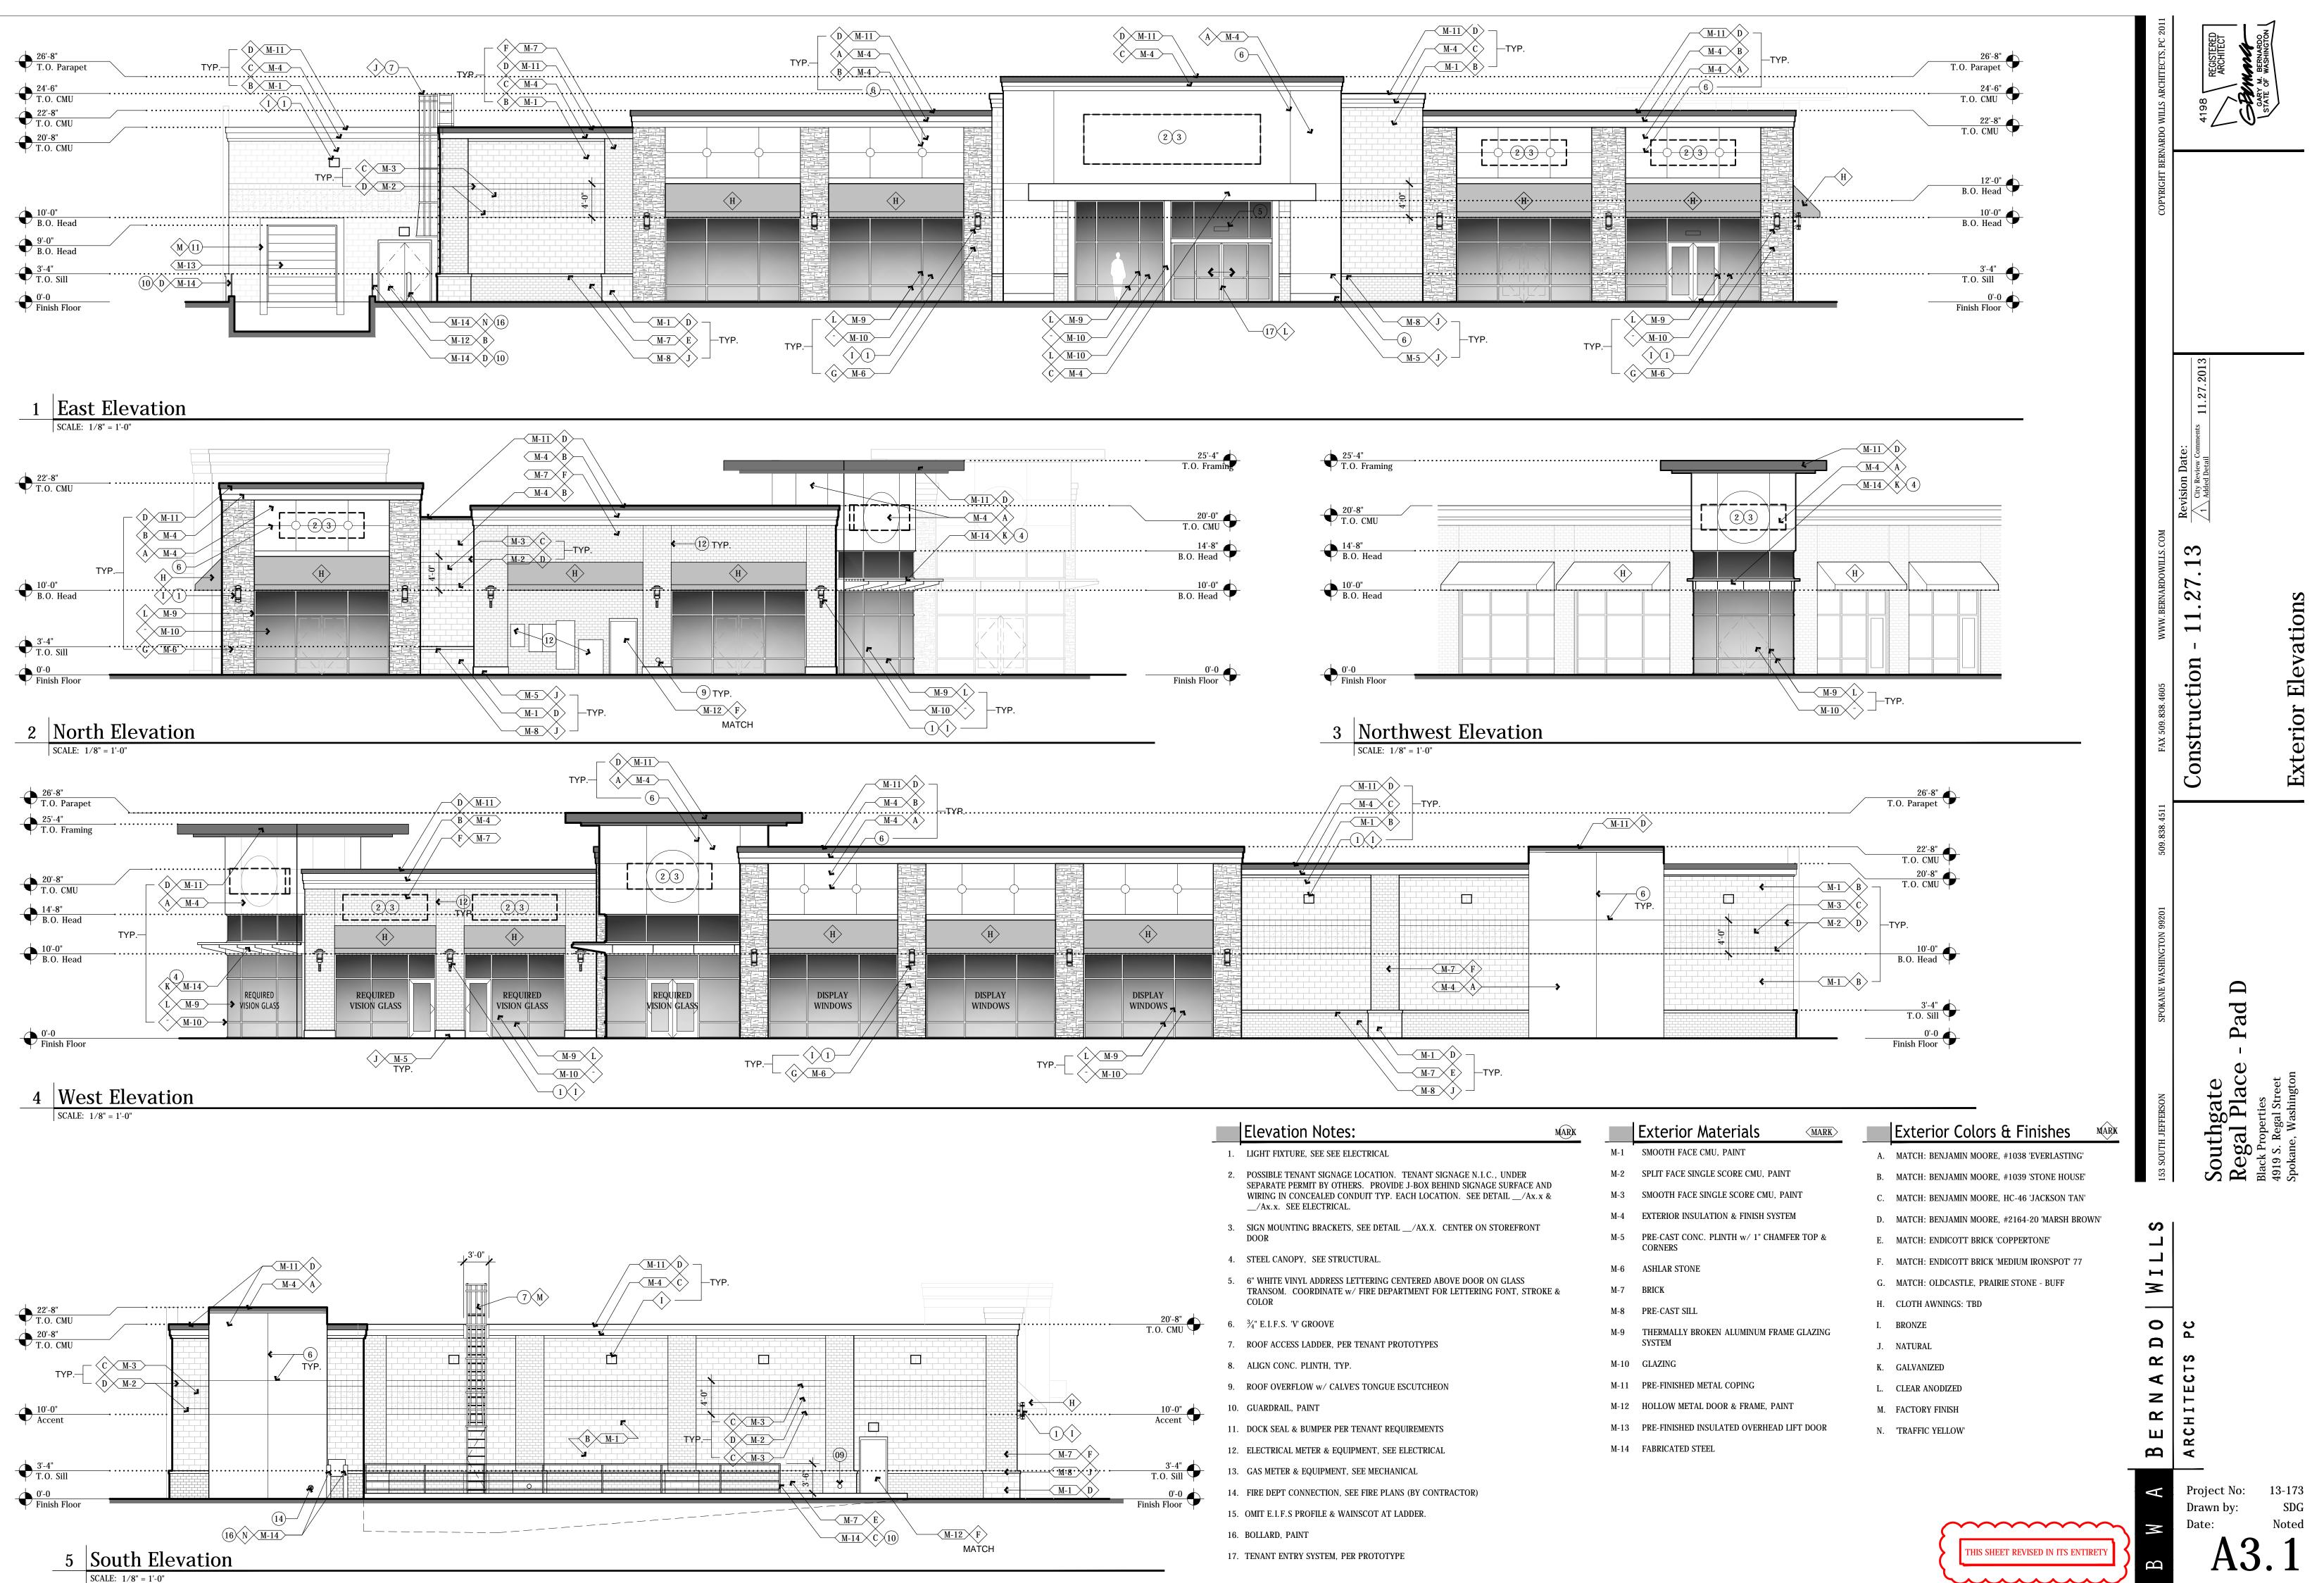

 \dots